



REDLINED

WEFT

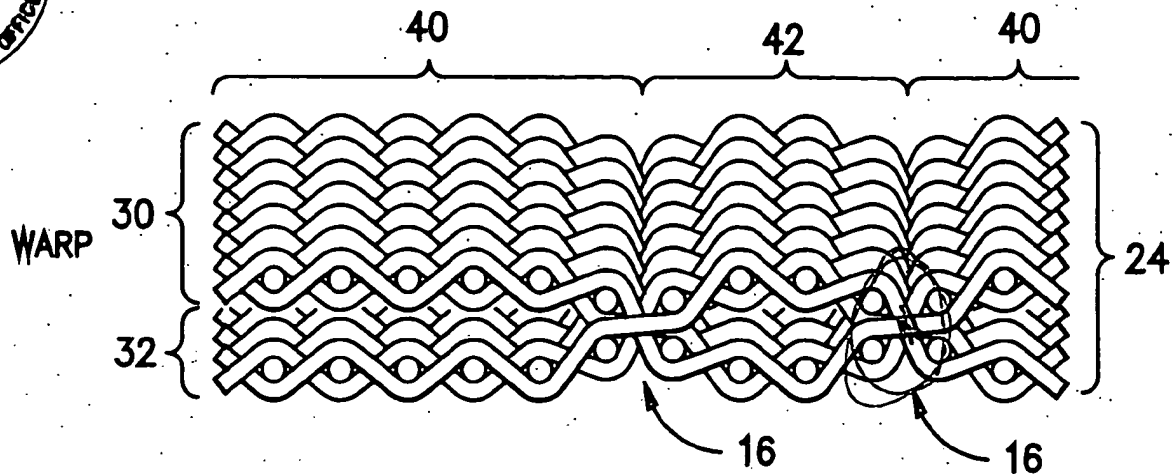


FIG. -5-

Proposed
Changes
Acceptable-
Need
Corrected
Replacement
Sheet

WEFT

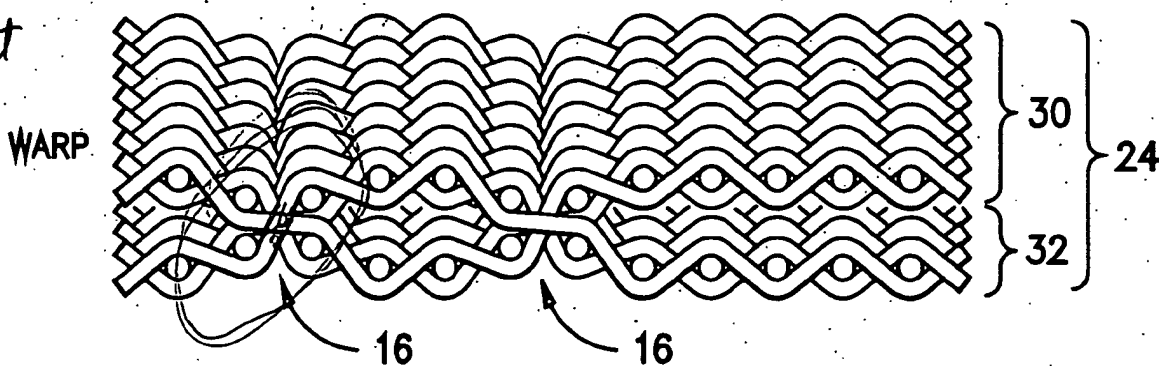


FIG. -6-

REDLINED